


General Notes:
 -Drawings are property of Brad Dayton Drafting & Design. (BDD&D) No reproduction of these drawings is allowed without the written permission from BDD&D.
 -BDD&D assumes no liability for any errors or omissions from the use of these drawings
 -All measurements to be verified by Contractor on-site
 -Do not scale drawings.
 Work from given dimensions
 -Drawings are to be printed on 11"x17" paper to be to proper scale as shown



VIC AVE E NORTH SERVICE ROAD

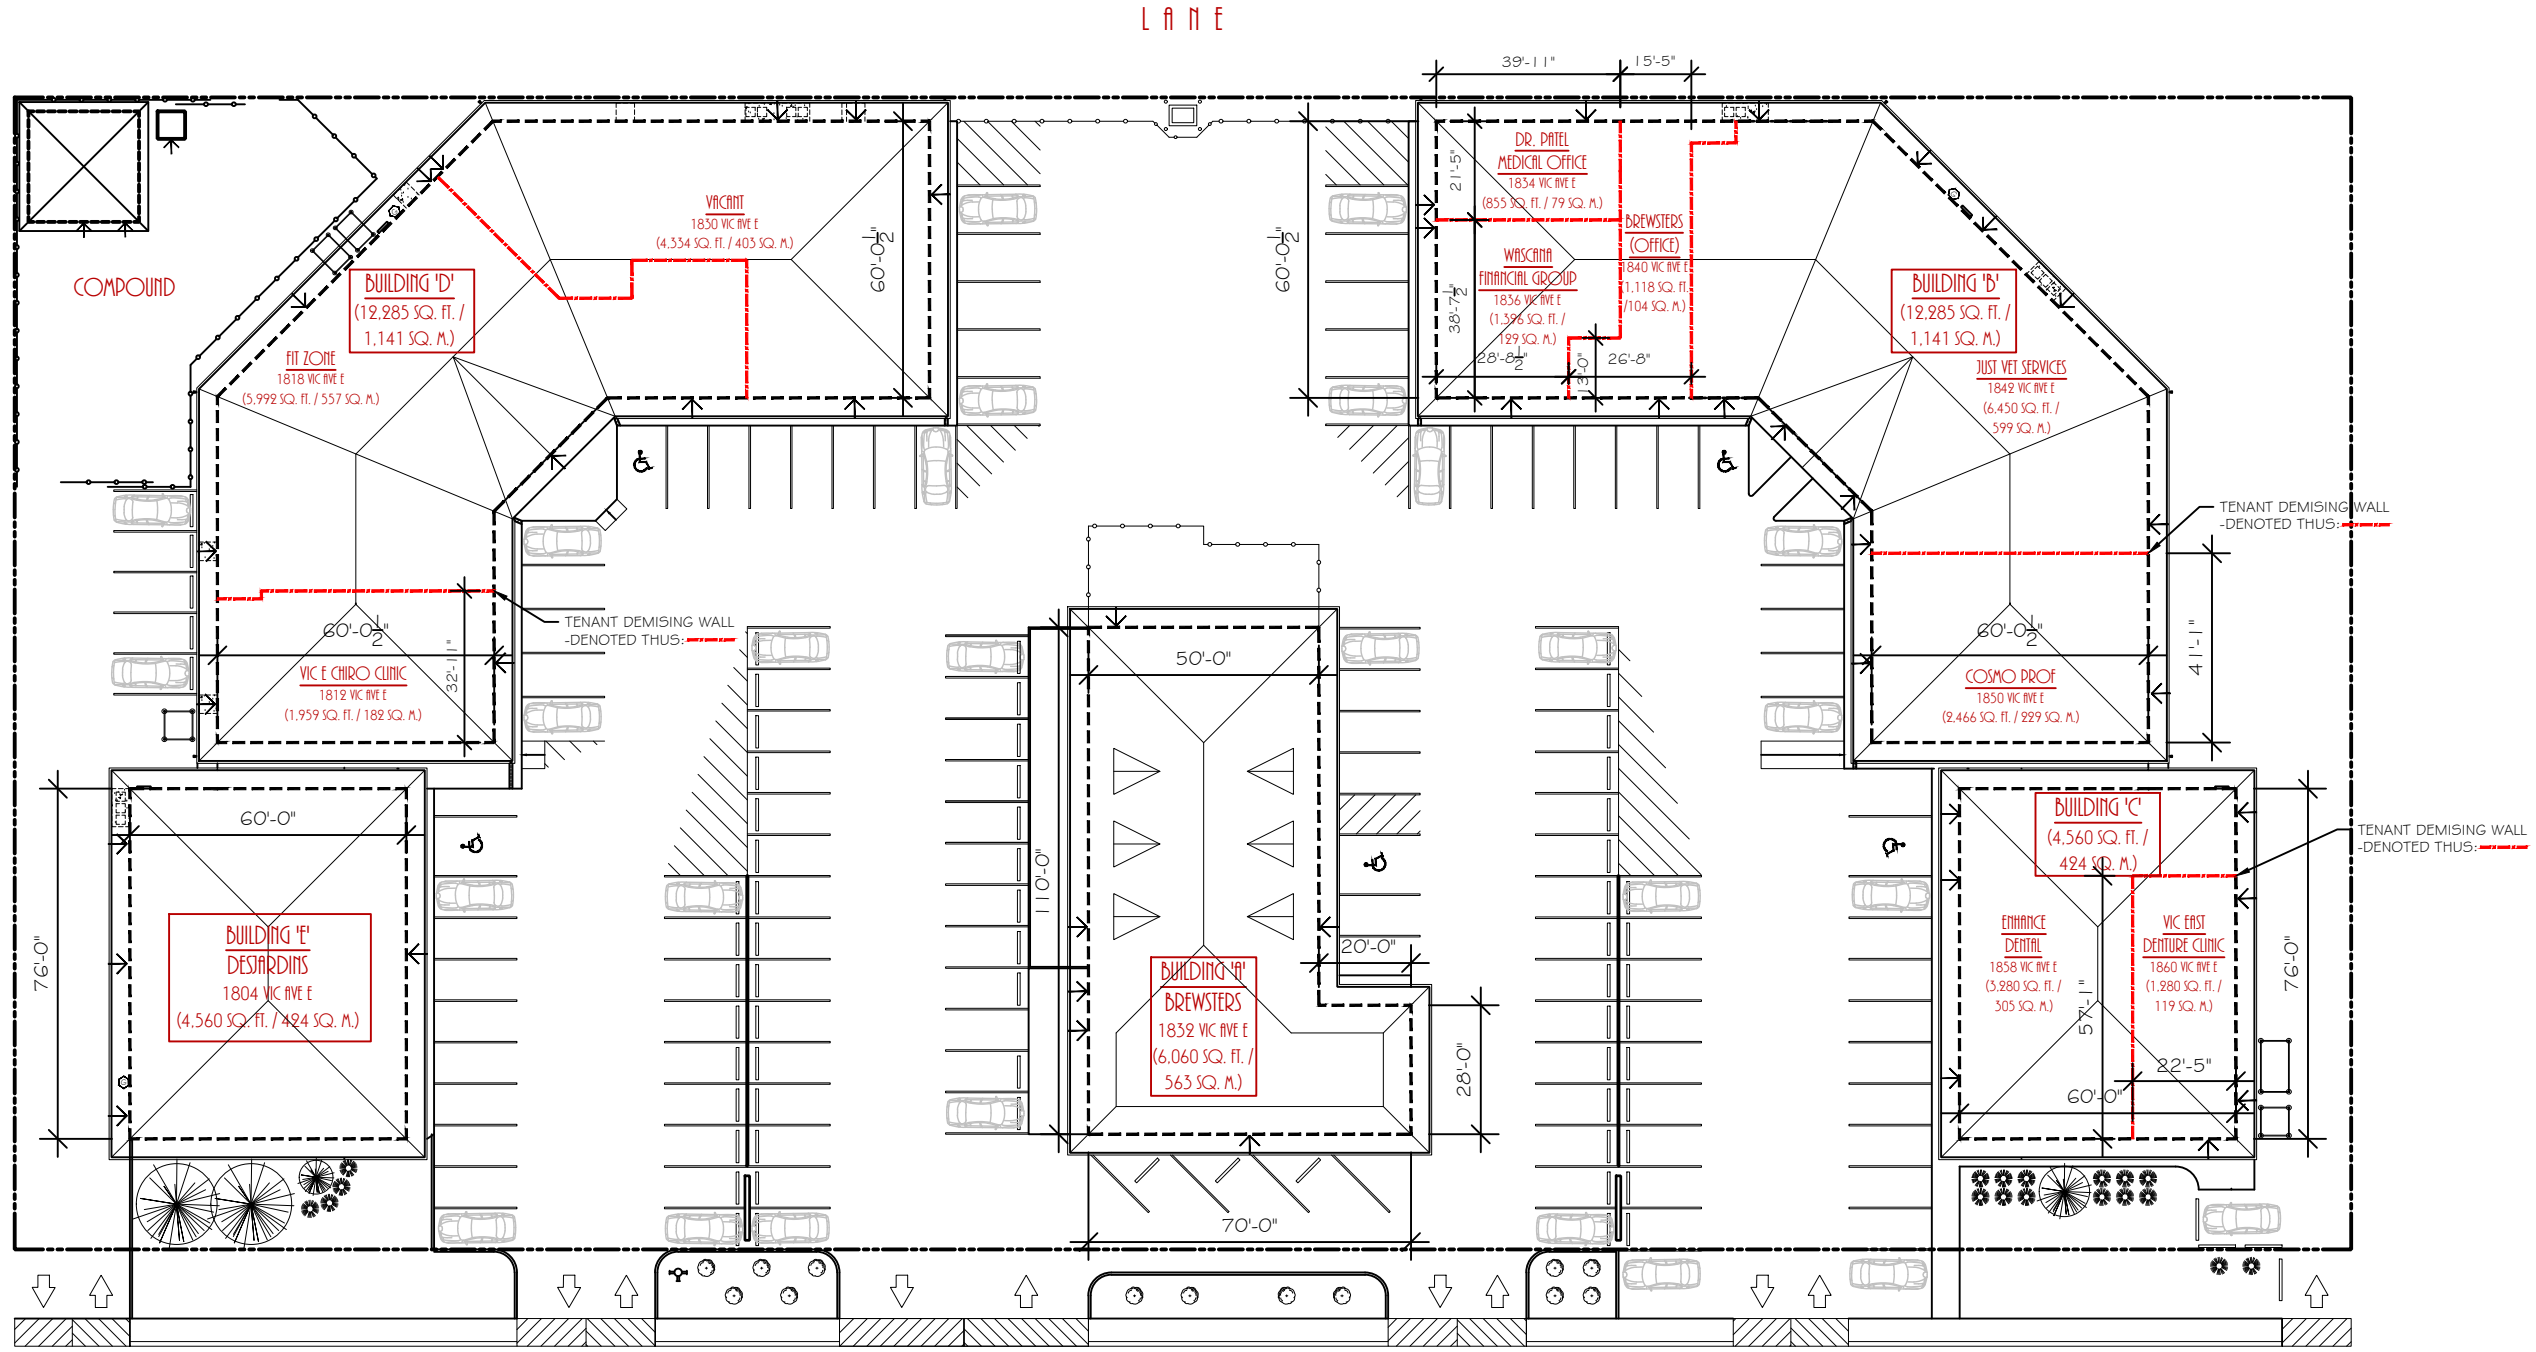

171208 AS-BUILT
 171206 SITE MEASUREMENT

Seals
**PRELIMINARY
 NOT FOR
 CONSTRUCTION**

Project Title
 Victoria East Plaza
 Site As-built
 Regina, SK

Drawing Title
 Site Plan

PROJECT NUMBER J1732	DRAWING NUMBER A-1
DATE 1/7/208	SCALE AS NOTED
DRAWN BY BJD	CHECKED BY TK / DS